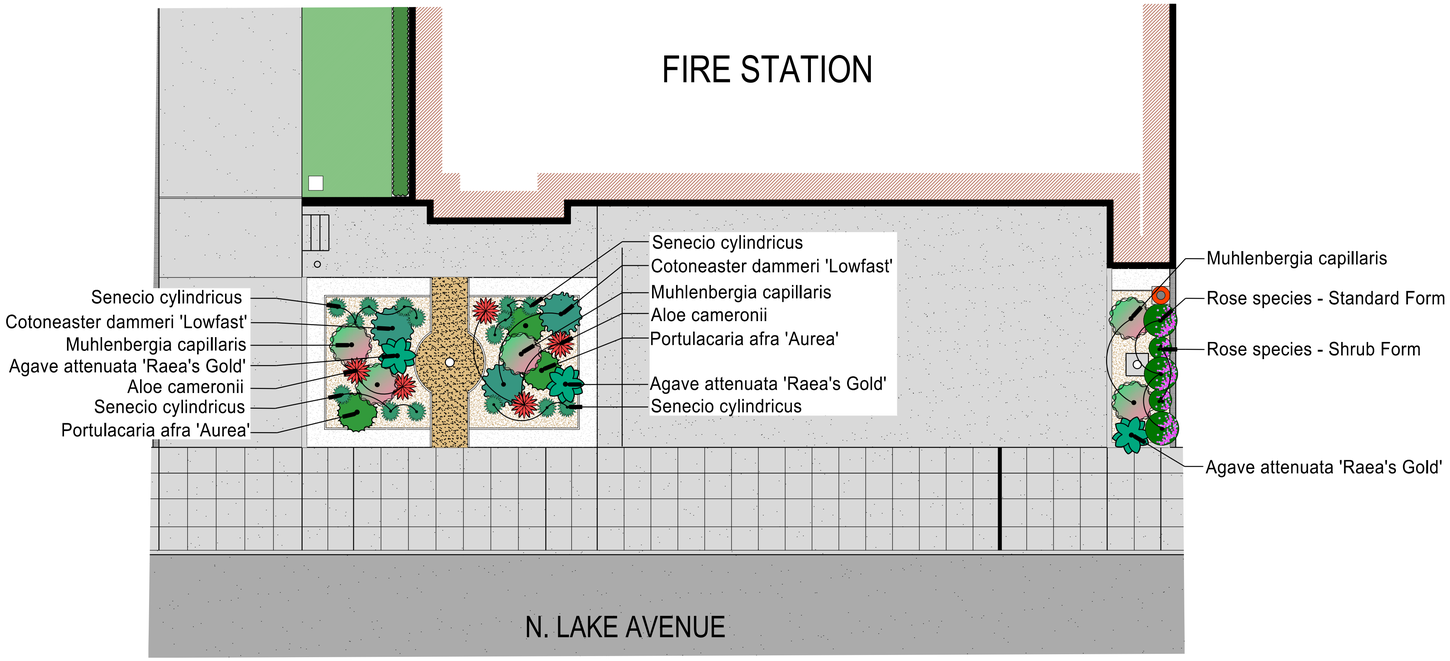

PLANT LEGEND

Symbol	Botanical Name	Common Name
	Agave attenuata 'Raea's Gold'	Golden Foxtail Agave
	Aloe cameronii	Red Aloe
	Cotoneaster dammeri 'Lowfast'	Bearberry Cotoneaster
	Muhlenbergia capillaris	Pink Muhly
	Portulacaria afra 'Aurea'	Yellow Rainbow Bush
	Rose Species	Rose - Standard Form
	Rose Species	Rose - Shrub Form

2" Thick Wood Chip Mulch
Decomposed Granite
Gravel

PASADENA WATER AND POWER

Drought Tolerant Landscape Plan

Fire Station 33

515 N. Lake Avenue

RECORD DRAWING

Pasadena, California

SCALE: 1/8"=1'-0"

8' 0' 8' 16'