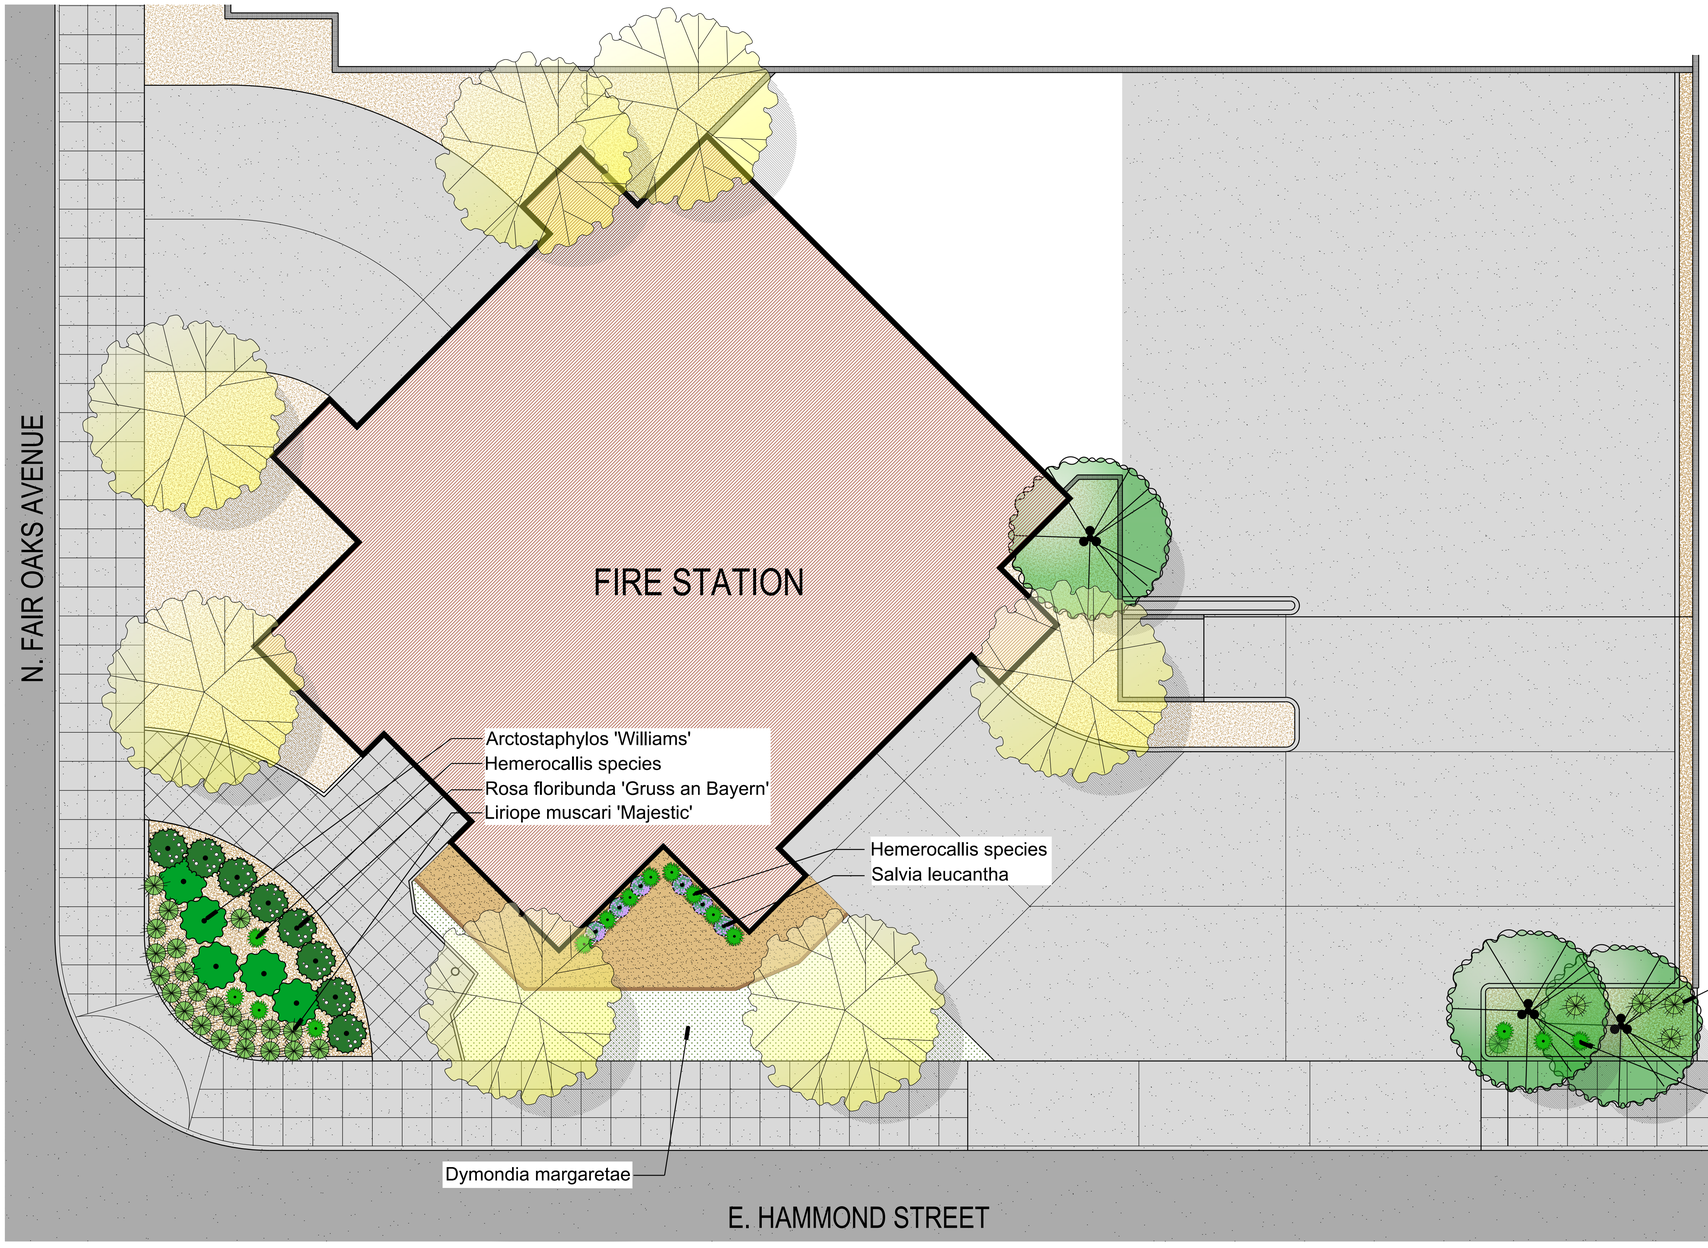

PLANT LEGEND

Symbol	Botanical Name	Common Name
	Arctostaphylos 'Williams'	Williams Manzanita
	Hemerocallis species	Daylily
	Liriope muscari 'Majestic'	Majestic Turf Lily
	Rosa floribunda 'Gruss an Bayern'	Gruss an Bayern Rose
	Salvia leucantha	Mexican Bush Sage
	Dymondia margaretae	Silver Carpet
	Decomposed Granite	
	3" Thick Wood Chip Mulch	

PASADENA WATER AND POWER

Drought Tolerant Landscape Plan

Fire Station 36

1140 N. Fair Oaks Avenue

RECORD DRAWING

Pasadena, California

SCALE: 1/8"=1'-0"

8' 0' 8' 16'